


LEGEND


- VACUUM ENHANCED RECOVERY WELL
- SHALLOW RECOVERY WELL
- △ DEEP RECOVERY WELL
- VER WELL PIPING
- - - SHALLOW/DEEP WELL PIPING
- - - OWASA DISCHARGE LINE

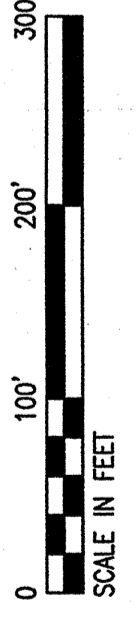

SCALE VERIFICATION
THIS BAR REPRESENTS
ONE INCH ON THE
ORIGINAL DRAWING.
USE TO VERIFY FIGURE
REPRODUCTION SCALE

REV. ISSUED DATE DESCRIPTION

1	03/12/99	OWNER'S REVIEW	XX	XXX
0	01/19/99	OWNER'S REVIEW	XX	XXX

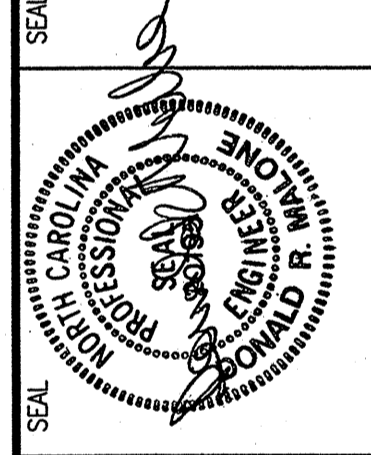

ARCADIS
ARCADIS G&M of North Carolina, Inc.
6000 Cornerstone Drive, Suite 300
Raleigh, NC 27607
Tel: 919-854-1232 Fax: 919-854-5448
www.arcadis-us.com

AIRPORT ROAD WASTE DISPOSAL AREA
THE UNIVERSITY OF NORTH CAROLINA AT CHAPEL HILL
CHAPEL HILL, NORTH CAROLINA

AS-BUILT SITE PLAN AND PIPING LAYOUT

PROJECT NUMBER	NC000239.0015
TASK/MANAGER	A. PINNIX / J. SHILLIDY
LEAD DESIGN PROF.	D. MALONE / C. KALINOWSKI
TASK/PHASE NUMBER	0015
DRAWN BY	A. PINNIX
PROJECT NUMBER	NC000239.0015
DRAWING NUMBER	G-1