


LEGEND

- VACUUM ENHANCED RECOVERY WELL
- SHALLOW RECOVERY WELL
- DEEP RECOVERY WELL
- VER WELL PIPING
- SHALLOW/DEEP WELL PIPING
- OWASA DISCHARGE LINE

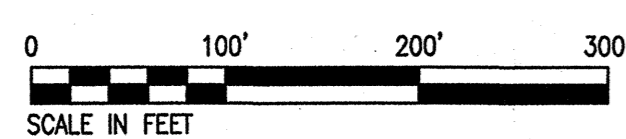


SCALE VERIFICATION
 THIS BAR REPRESENTS
 ONE INCH ON THE
 ORIGINAL DRAWING.
 USE TO VERIFY FIGURE
 REPRODUCTION SCALE

Acad Version : R16.0e (LMS Tech)
 User Name : gpinix
 © 2006 ARCADIS G&M, INC.
 Date/Time : Wed, 04 Oct 2006 10:25am
 Path Name : G:\ENV\UNIVNC\Airport Road\NC000239.0015\Construction Completion Report\Figures\UNCAR-DWGS3.dwg
 Layout Title: SHEET 3
 Current Plotstyle: BLM.dwt
 Plot Name : G:\ENV\UNIVNC\Airport Road\NC000239.0015\Construction Completion Report\Figures\UNCAR-DWGS3.dwg

REV.	ISSUED DATE	DESCRIPTION	XX	XXX
1	03/12/99	OWNER'S REVIEW	XX	XXX
0	01/19/99	OWNER'S REVIEW	XX	XXX

KEYPLAN

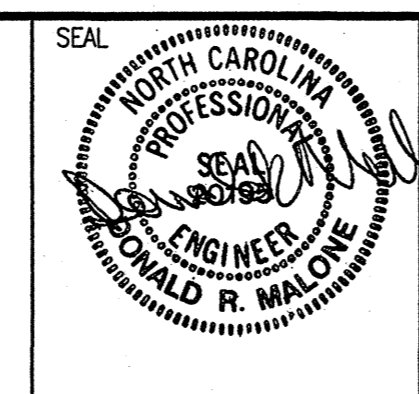

SEAL

ARCADIS

ARCADIS G&M of North Carolina, Inc.
 801 Corporate Center Drive, Suite 300
 Raleigh, NC 27607
 Tel: 919-854-1282 Fax: 919-854-5448
 www.arcadis-us.com

AIRPORT ROAD WASTE DISPOSAL AREA
THE UNIVERSITY OF NORTH CAROLINA AT CHAPEL HILL
CHAPEL HILL, NORTH CAROLINA

PROJECT MANAGER
J. SHILLIDAY

TASK MANAGER
A. PINNIX

SHEET TITLE
AS-BUILT SITE PLAN AND PIPING LAYOUT

LEAD DESIGN PROF.
D. MALONE

TASK/PHASE NUMBER
0015

PROJECT NUMBER
NC000239.0015

CHECKED BY
C. KALINOWSKI

DRAWN BY
A. PINNIX

DRAWING NUMBER
G-1